


**EXIST. CONDITIONS - RESIDENCE & GUEST HOUSE**  
**2901 FLAMINGO DR, MIAMI BEACH, FL 33021**

Date of Issue:  
 Revisions:  
 Submittal Type:  
**AS-BUILT DOCUMENTATION**

Supervised by:  
 LP  
 Drawn By:  
 CM

Sheet title  
**AS-BUILT SECOND FLOOR PLAN**

Sheet Number:  
**A-002**

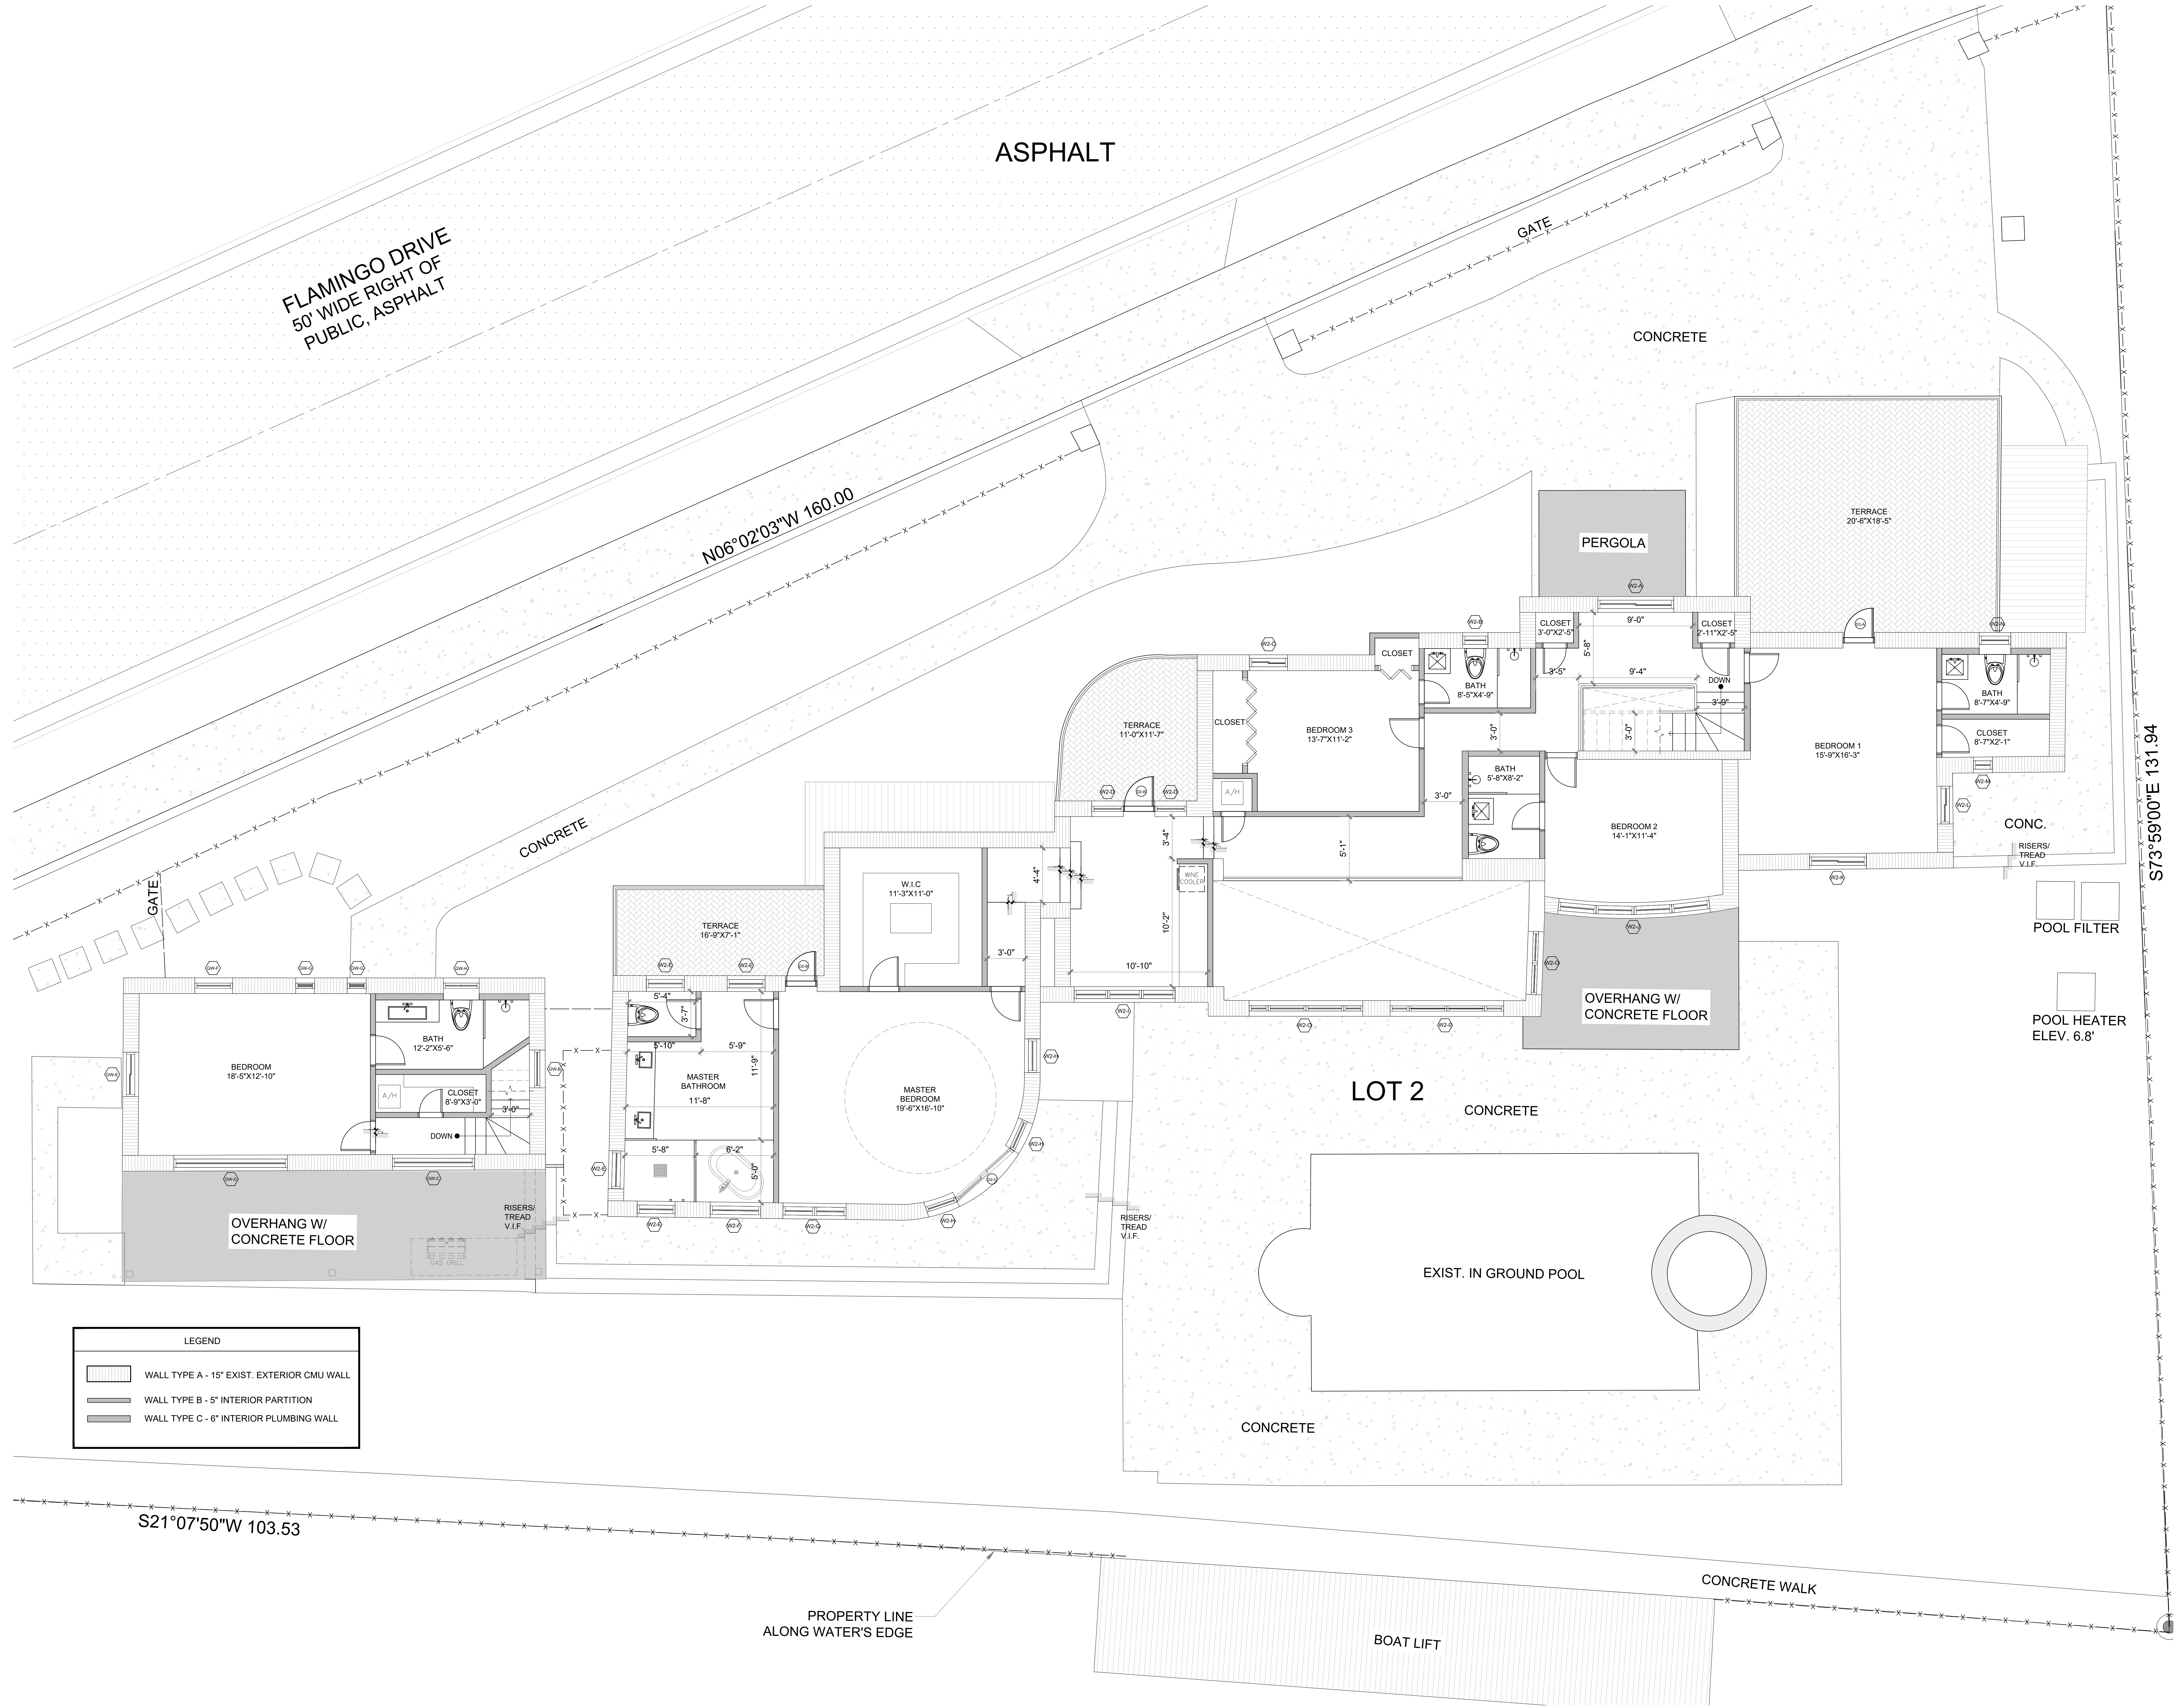

**LEGEND**

	WALL TYPE A - 15" EXIST. EXTERIOR CMU WALL
	WALL TYPE B - 5" INTERIOR PARTITION
	WALL TYPE C - 6" INTERIOR PLUMBING WALL